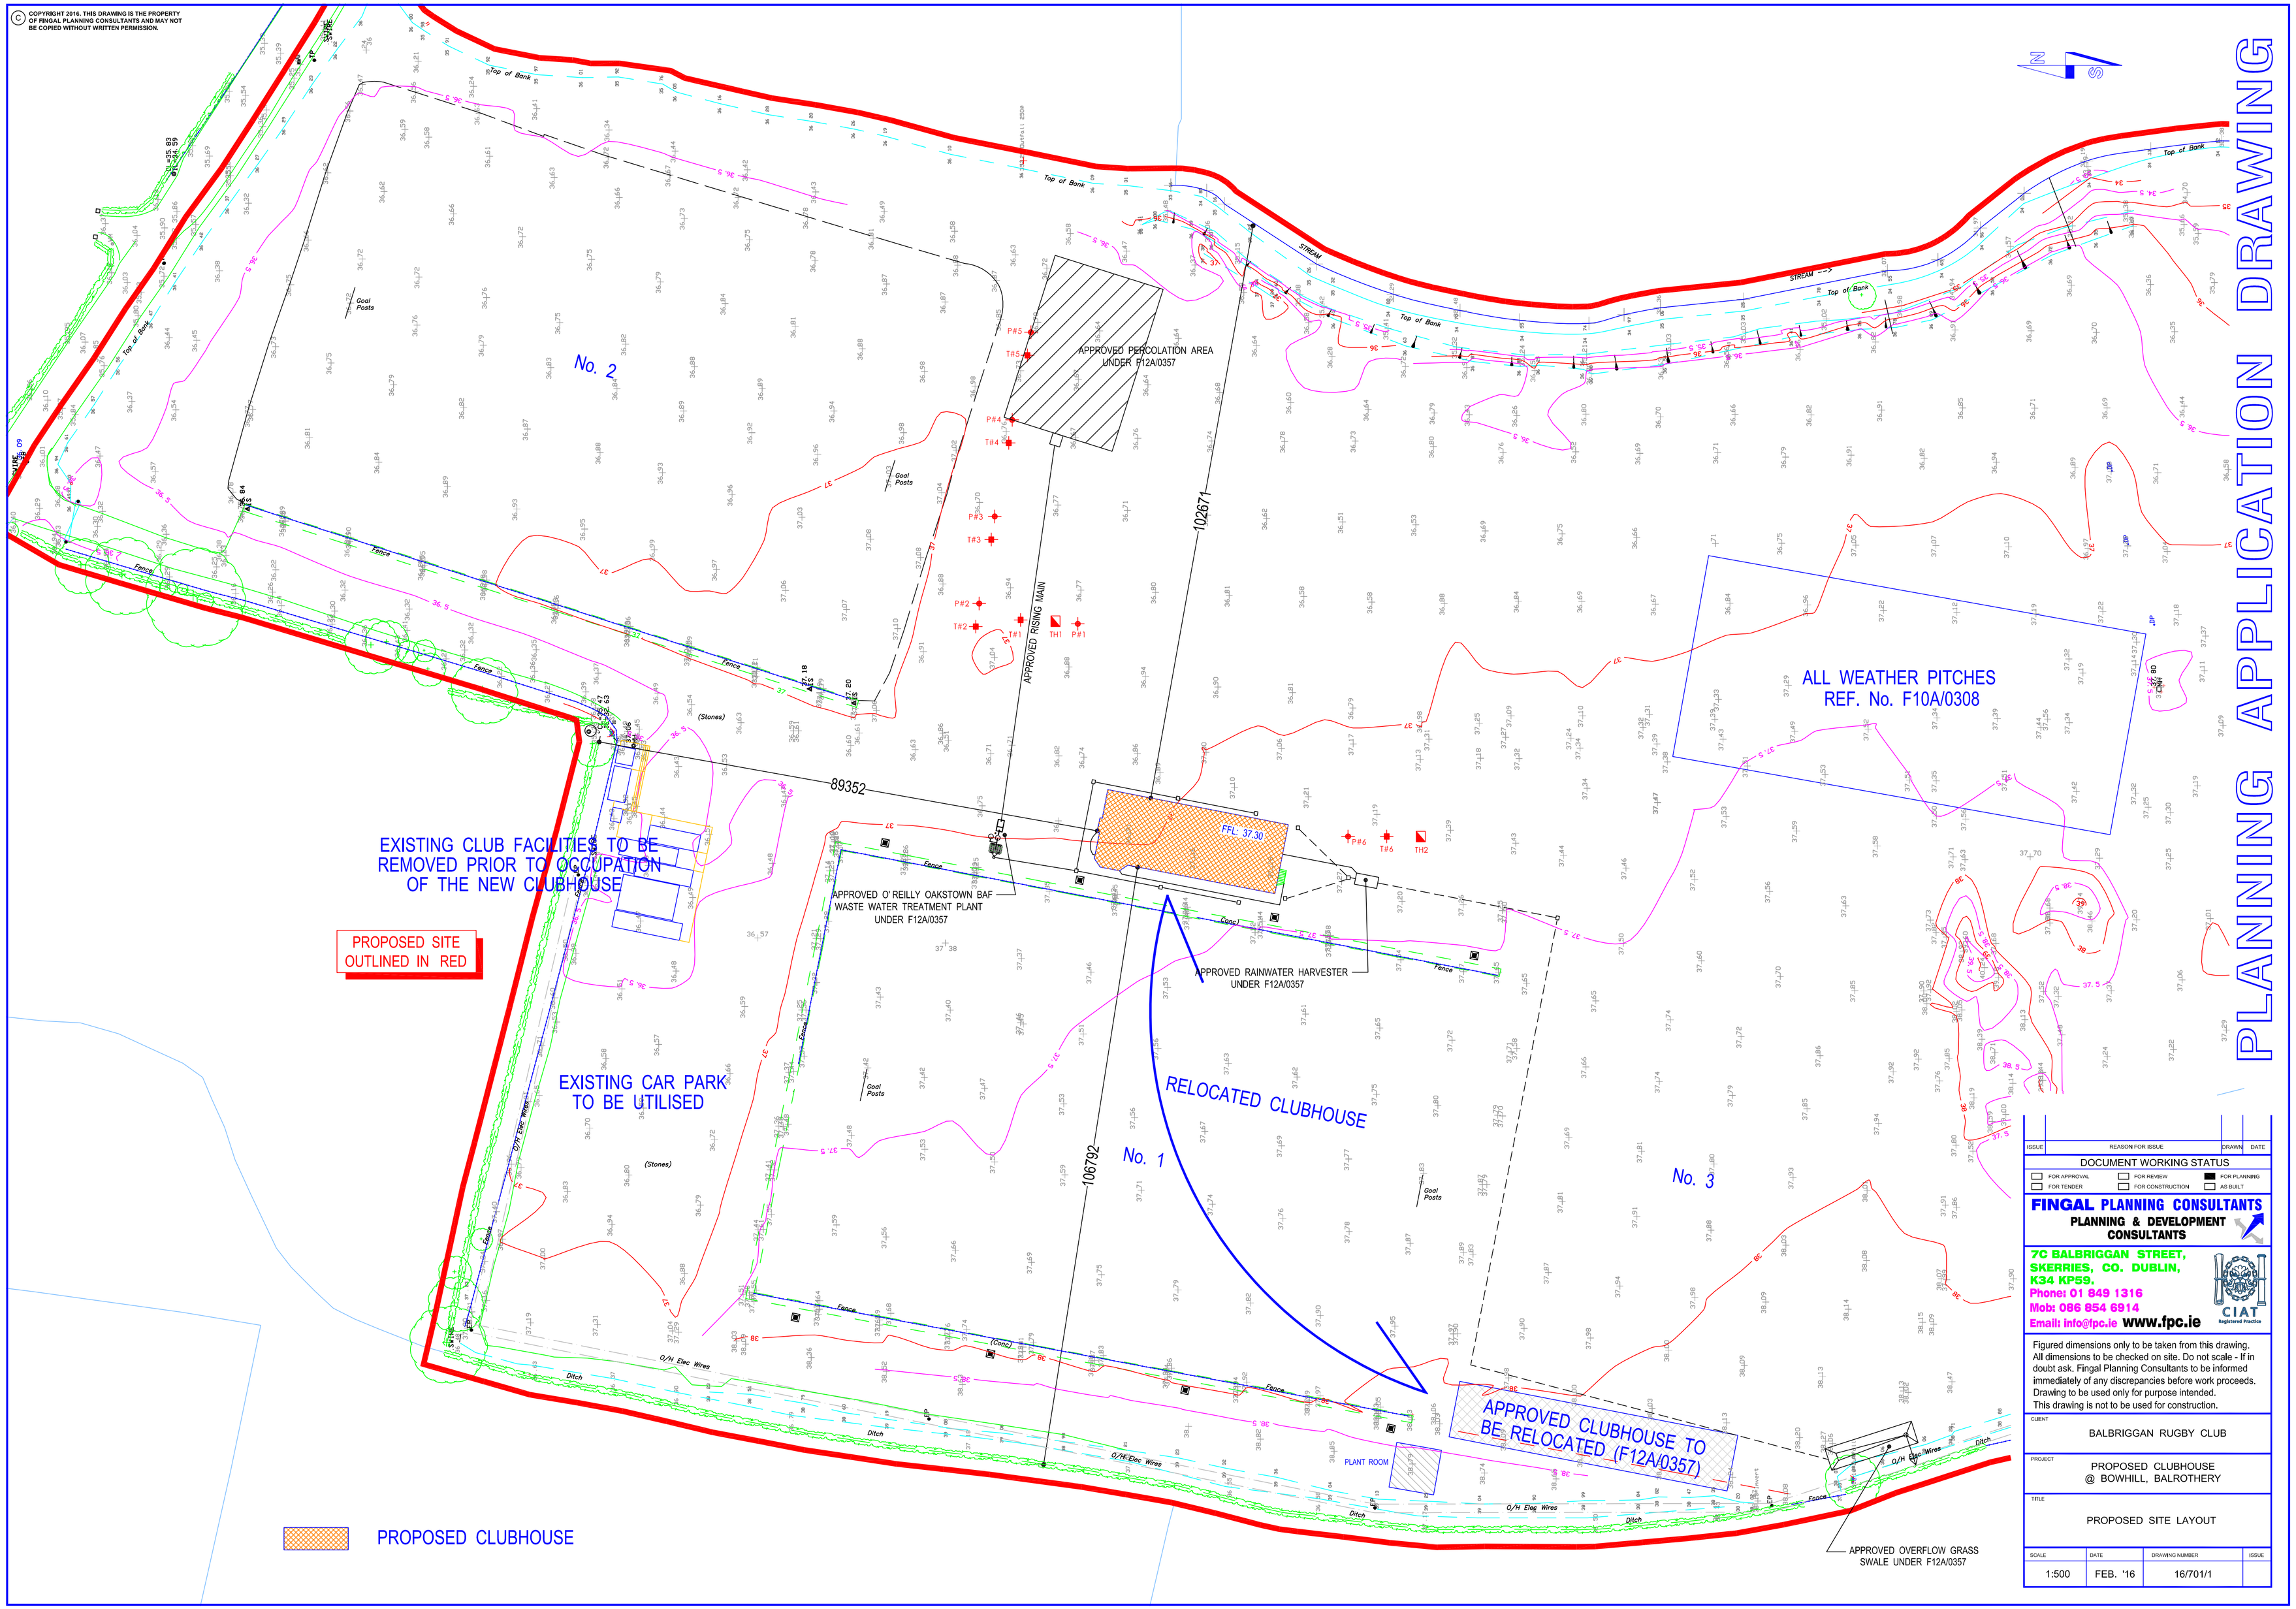

PLANNING APPLICATION DRAWING
© COPYRIGHT 2016. THIS DRAWING IS THE PROPERTY OF FINGAL PLANNING CONSULTANTS AND MAY NOT BE COPIED WITHOUT WRITTEN PERMISSION.
No. 2
No. 1
No. 3
APPROVED PERCOLATION AREA UNDER F12A/0357
APPROVED RISING MAIN
ALL WEATHER PITCHES REF. No. F10A/0308
EXISTING CLUB FACILITIES TO BE REMOVED PRIOR TO OCCUPATION OF THE NEW CLUBHOUSE
PROPOSED SITE OUTLINED IN RED
EXISTING CAR PARK TO BE UTILISED
APPROVED O' REILLY OAKSTOWN BAF WASTE WATER TREATMENT PLANT UNDER F12A/0357
APPROVED RAINWATER HARVESTER UNDER F12A/0357
RELOCATED CLUBHOUSE
APPROVED CLUBHOUSE TO BE RELOCATED (F12A/0357)
PLANT ROOM
APPROVED OVERFLOW GRASS SWALE UNDER F12A/0357
PROPOSED CLUBHOUSE
89352
102671
106792
FFL: 37.30
Top of Bank
STREAM
Goal Posts
Fence
(Stones)
O/H Elec Wires
Ditch
ISSUE
REASON FOR ISSUE
DRAWN
DATE
DOCUMENT WORKING STATUS
FOR APPROVAL
FOR REVIEW
FOR PLANNING
FOR TENDER
FOR CONSTRUCTION
AS BUILT
FINGAL PLANNING CONSULTANTS
PLANNING & DEVELOPMENT CONSULTANTS
7C BALBRIGGAN STREET, SKERRIES, CO. DUBLIN, K34 KP59.
Phone: 01 849 1316
Mob: 086 854 6914
Email: info@fpc.ie www.fpc.ie
CIAT Registered Practice
Figured dimensions only to be taken from this drawing. All dimensions to be checked on site. Do not scale - If in doubt ask. Fingal Planning Consultants to be informed immediately of any discrepancies before work proceeds. Drawing to be used only for purpose intended. This drawing is not to be used for construction.
CLIENT
BALBRIGGAN RUGBY CLUB
PROJECT
PROPOSED CLUBHOUSE @ BOWHILL, BALROTHERY
TITLE
PROPOSED SITE LAYOUT
SCALE
1:500
DATE
FEB. '16
DRAWING NUMBER
16/701/1
ISSUE